


8TH TO 25TH FLOOR SEWER AND VENT LAYOUT

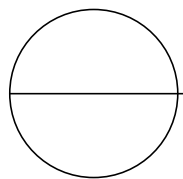

SCALE

1:250 MTS