


9TH-12TH FLOOR WATER DISTRIBUTION LAYOUT

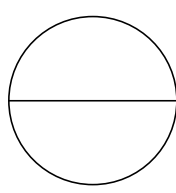

SCALE

1:250 MTS