PARTIAL ONE-LINE POWER RISER DIAGRAM(9TH FLR TO 15TH FLR)

1 E-04 SCALE: NTS

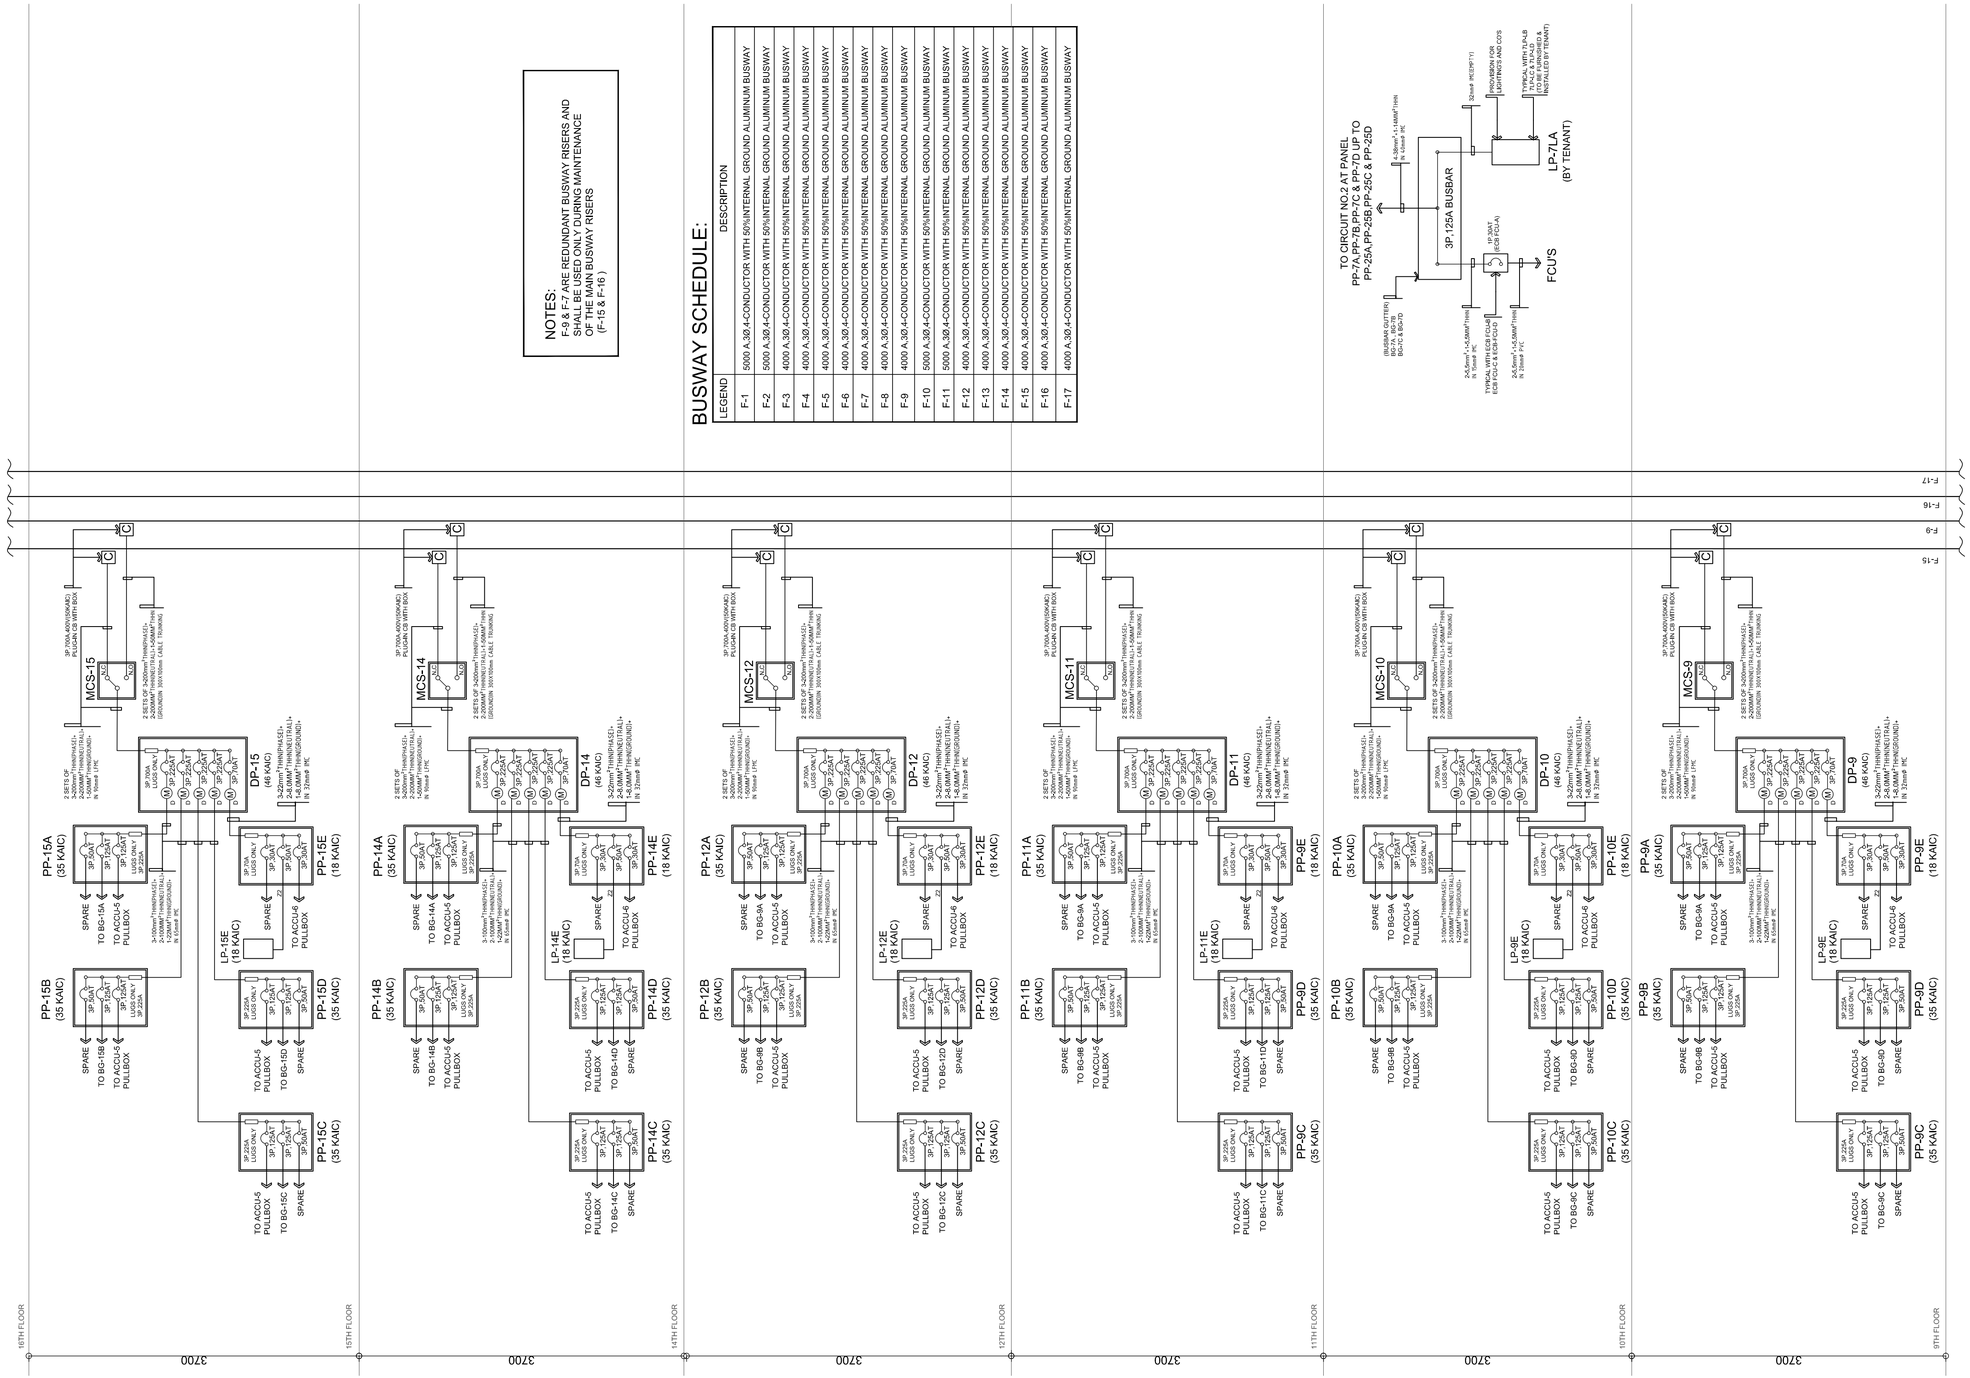

NOTES:

BUSWAY SCHEDULE:

LEGEND	DESCRIPTION
F-1	5000 A,3Ø,4-CONDUCTOR WITH 50%INTERNAL GROUND ALUMINUM BUSWAY
F-2	5000 A,3Ø,4-CONDUCTOR WITH 50%INTERNAL GROUND ALUMINUM BUSWAY
F-3	4000 A,3Ø,4-CONDUCTOR WITH 50%INTERNAL GROUND ALUMINUM BUSWAY
F-4	4000 A,3Ø,4-CONDUCTOR WITH 50%INTERNAL GROUND ALUMINUM BUSWAY
F-5	4000 A,3Ø,4-CONDUCTOR WITH 50%INTERNAL GROUND ALUMINUM BUSWAY
F-6	4000 A,3Ø,4-CONDUCTOR WITH 50%INTERNAL GROUND ALUMINUM BUSWAY
F-7	4000 A,3Ø,4-CONDUCTOR WITH 50%INTERNAL GROUND ALUMINUM BUSWAY
F-8	4000 A,3Ø,4-CONDUCTOR WITH 50%INTERNAL GROUND ALUMINUM BUSWAY
F-9	4000 A,3Ø,4-CONDUCTOR WITH 50%INTERNAL GROUND ALUMINUM BUSWAY
F-10	5000 A,3Ø,4-CONDUCTOR WITH 50%INTERNAL GROUND ALUMINUM BUSWAY
F-11	5000 A,3Ø,4-CONDUCTOR WITH 50%INTERNAL GROUND ALUMINUM BUSWAY
F-12	4000 A,3Ø,4-CONDUCTOR WITH 50%INTERNAL GROUND ALUMINUM BUSWAY
F-13	4000 A,3Ø,4-CONDUCTOR WITH 50%INTERNAL GROUND ALUMINUM BUSWAY
F-14	4000 A,3Ø,4-CONDUCTOR WITH 50%INTERNAL GROUND ALUMINUM BUSWAY
F-15	4000 A,3Ø,4-CONDUCTOR WITH 50%INTERNAL GROUND ALUMINUM BUSWAY
F-16	4000 A,3Ø,4-CONDUCTOR WITH 50%INTERNAL GROUND ALUMINUM BUSWAY
F-17	4000 A,3Ø,4-CONDUCTOR WITH 50%INTERNAL GROUND ALUMINUM BUSWAY

OWNER/CLIENT:	CONSULTANT: ARCHITECTURAL	PROJECT TITLE:	GENERAL CONTRACTOR:
Eton Properties Philippines, Inc. 8/F ALLIED BANK CENTER, 6754 AYALA AVE. COR. LEGASPI ST. MAKATI CITY	**EDLEA Engineering Consultancy** Rm 103, Mezzanine Floor, VIR Building 1840 E. Rodriguez Sr. Ave., Cubao, Q.C. Tel Fax : 7232951 Email : edlea.espinosa@yahoo.com	**ETON CYBERPOD CENTRIS 5** ETON CENTRIS, EDSA COR. QUEZON AVE. QUEZON CITY, PHILIPPINES	**DATEM** YOUR TRUSTED BUILDER 99 MINDANAO AVENUE, BAHAY TORO, QUEZON CITY [TEL.: 8923 2836 FAX.: 8453 0156]

KINETIC PHILS. ELECTRICAL CONSTRUCTION, INC.
PCAB License No 30330 Cat AAA I PCAB Reg No 2004255 I ISO 9001:2008 Certified
GIL M. MOSTOLES
PROFESSIONAL ELECTRICAL ENGINEER
PRC NO.: 2349 | TIN NO.: 139-584-226
PTR NO.: 10307425 | DATE: JAN. 03, 2019

SCALE:	AS SHOWN
REVISION:	-
CAD BY:	MJ DAYAG
CHECKED BY:	-
DATE:	OCTOBER 02,2019

SHEET CONTENT: **AS-BUILT**

SHEET NO: **E-04**

REF. DWG: